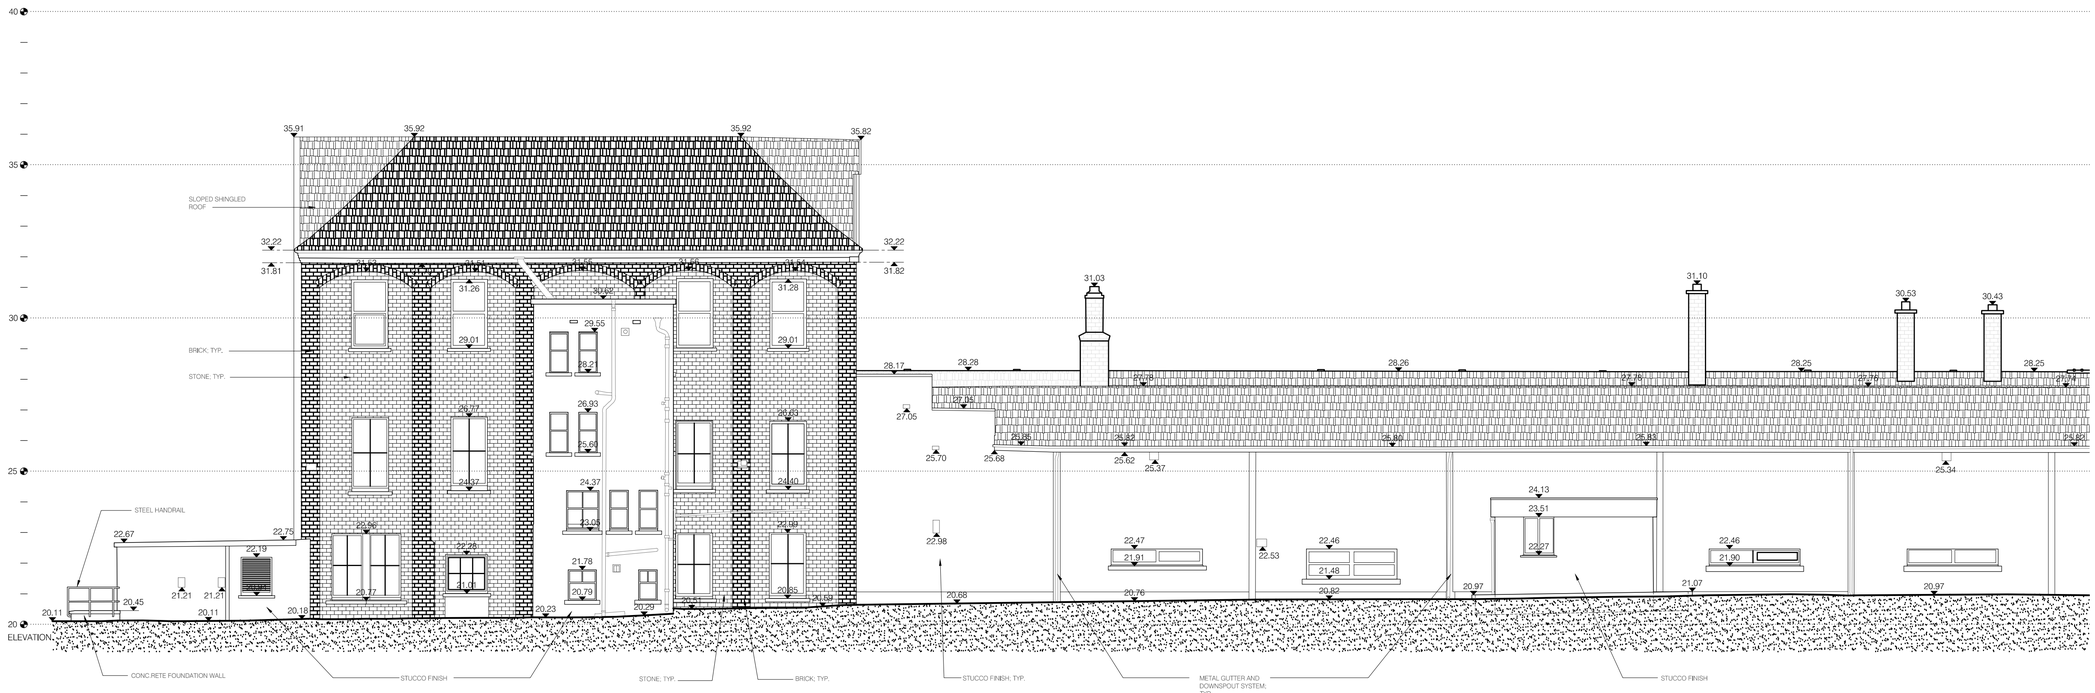

1 HAUGHTON BUILDING - ELEVATION 1A

−1 0 1 3 5 METERS

SCALE: 1:100

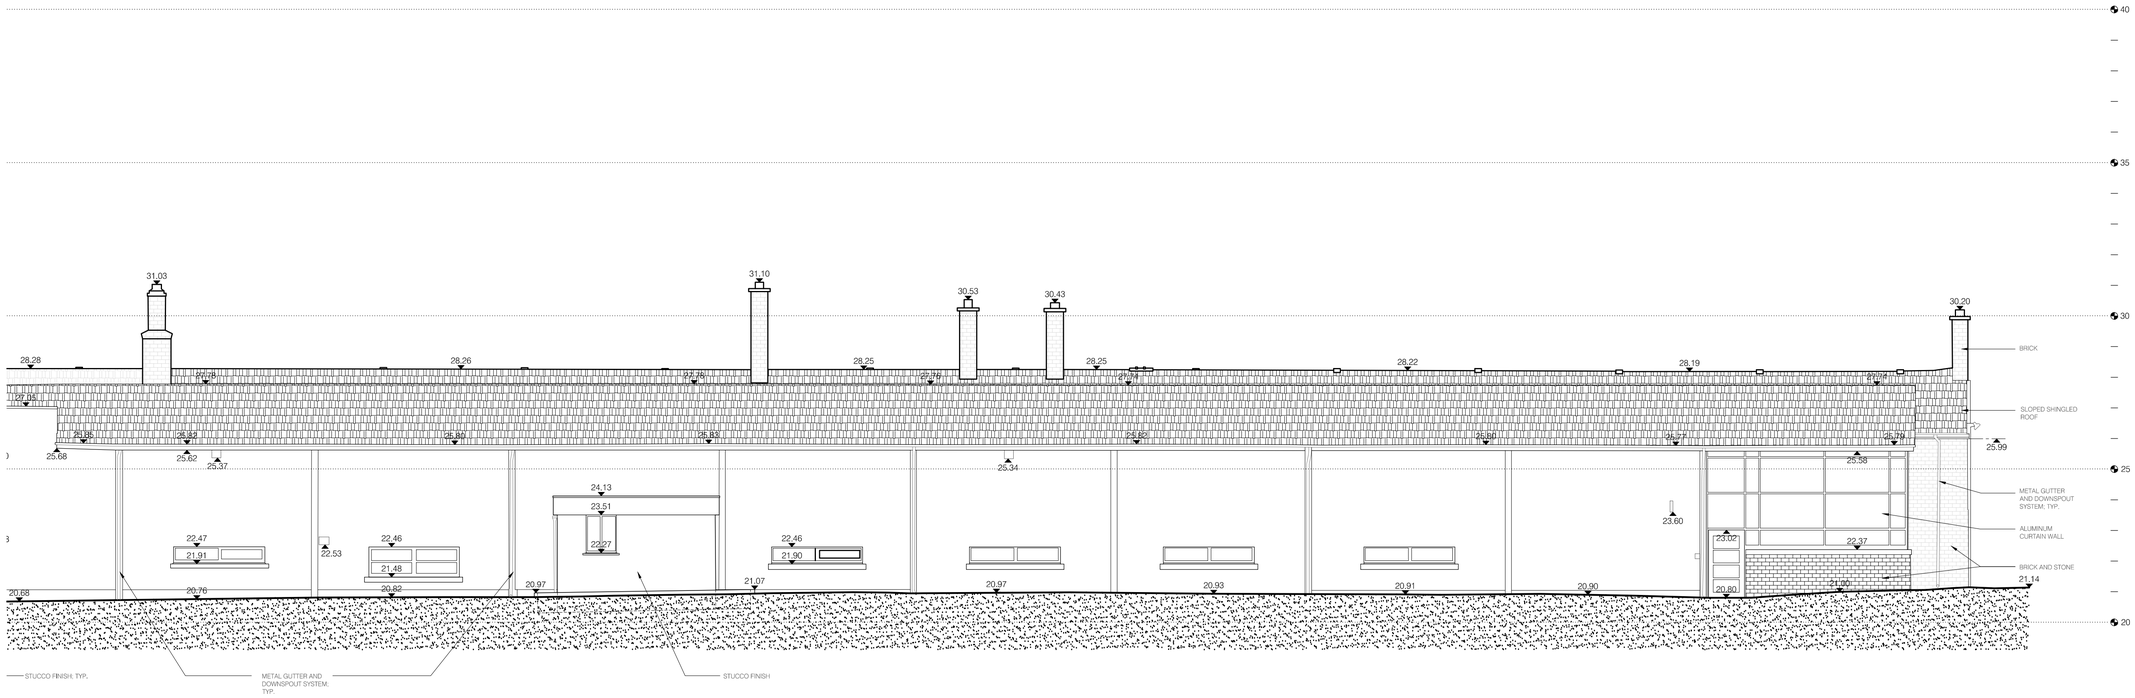

2 HAUGHTON BUILDING - ELEVATION 1B

−1 0 1 3 5 METERS

SCALE: 1:100

LEGEND

Architectural details

- Floor to Ceiling height / Finished Floor level
- Spot height
- Window sill and head heights
- Stairs
- Structural Columns
- Interior Walls
- Partition Type (see schedule)
- Plumbing fixtures, toilets, sinks
- Cut line
- Door (with head height)
- Sliding door
- Window
- Glazing Type (see schedule)
- Door Type (see schedule)
- Railing
- Fencing

Murphy Surveys Ltd. Disclaimer

The user or recipient of this survey data understands and acknowledges this data may be inaccurate or contain errors or omissions and the user or recipient assumes full responsibility for any risks or damages resulting from, arising from, or in connection with any use of or reliance upon data displayed herein. Although significant care has been exercised to produce surveys that satisfy survey accuracy standards, these surveys are only as accurate as the source data from which they were compiled. Although all reasonable steps have been taken to locate all features visible at the time of the survey, there is no guarantee that all will be shown on the drawing, as some above ground features may have obstructed the survey. Wherever possible, areas unable to be surveyed will be labelled as "UTS".

The Company shall not be liable for any inaccuracy of the data provided beyond the specified scale or accuracy, or for any matters resulting from their use for purposes other than that stated in the Contract. No liability shall attach to the Surveyor in respect of any consequential loss or damages suffered by the Client. The Client must promptly notify the Company of any errors in mapping of which it becomes aware. If misleading, inaccurate or otherwise inappropriate information is brought to the Company's attention or the Company itself identifies any such imprecision or error in a survey, it shall use its reasonable endeavours to fix or remove it and if necessary in certain instances, the Company being on notice of any such misleading, inaccurate or otherwise inappropriate information, it will re-conduct the survey and reproduce the data to within the specified scale or accuracy.

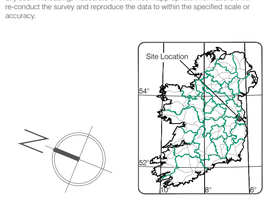

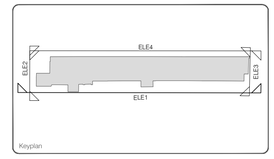

Surveyed by :	Murphy Surveys Ltd.	Date: APRIL 2015	Datum: Malin Head
Drawn by :	MSL	Date: MAY 2015	Grid System:
Checked by :	MK	Date: 26/05/2015	Irish National Grid ☐ ITM ☒

Revisions

No.	Date	Description
0	13/05/2015	ISSUED FINAL DRAWINGS
1	26/05/2015	DETAILS ADDED

No. 318

THE SURVEY ASSOCIATION FULL MEMBER

EUROPEAN GPR ASSOCIATION

murphy SURVEYS
GLOBAL CONSULTING SURVEYORS

Topographic surveys, Measured Building Surveys, Setting-Out, As-Built Surveys, Hydrographic Surveys, Legal Mapping, Pipeline Surveys, Services Location, Ground Penetrating Radar, Laser Scanning, Rectified Photography

Kildare Cork Belfast Glasgow London

Head Office
Global House
Kilcullen Business Campus
Kilcullen Co. Kildare
Ireland

Phone: (+353) 045 484040
Fax: (+353) 045 484004
Email: info@murphysurveys.ie

www.murphysurveys.ie

Client :	O'CONNOR SUTTON CRONIN
Project :	NEW CHILDRENS HOSPITAL - EXTENDED SCOPE
Date : 13/05/2015	**Scale :** 1:100
Description :	HAUGHTON BUILDING - ELEVATIONS
Drawing Number :	NCH-G-MY-TS-XX-ST-1310

© Copyright 2015 MURPHY SURVEYS LTD